

830

— THIRD —

EAST 51ST STREET


Entire Floor 10
12,332 RSF
Core & Shell

For leasing information, lease contact

Ron Lo Russo
212.841.7979
Ron.LoRusso@cushwake.com

Harley Dalton
212.589.5106
Harley.Dalton@cushwake.com

Pierce Hance
212.841.7641
Pierce.Hance@cushwake.com

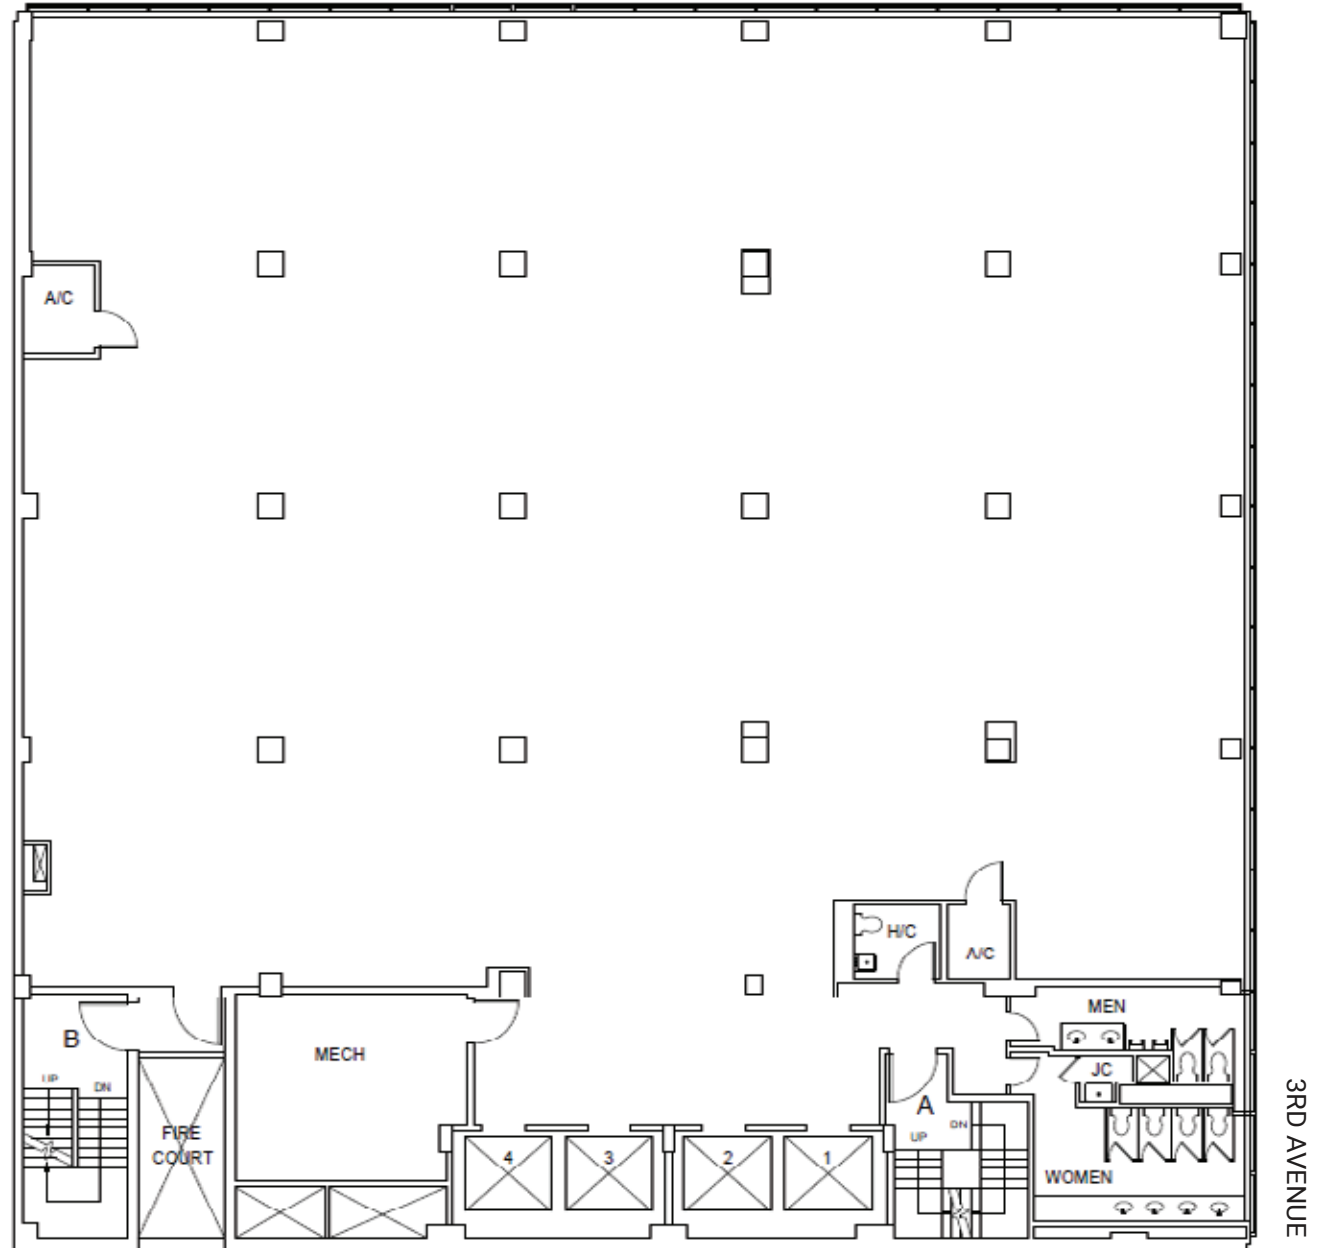

830

— THIRD —

Entire Floor 10
12,332 RSF
As-Built

For leasing information, please contact

Ron Lo Russo
212.841.7979
Ron.LoRusso@cushwake.com

Harley Dalton
212.589.5106
Harley.Dalton@cushwake.com

Pierce Hance
212.841.7641
Pierce.Hance@cushwake.com



OPEN AREA: 1 ROOMS: 15 KITCHEN: 1